


Katy MOB I

705 S Fry Rd
Katy, TX 77450
www.cbre.com/properties

Suite 100 - 3,633 RSF

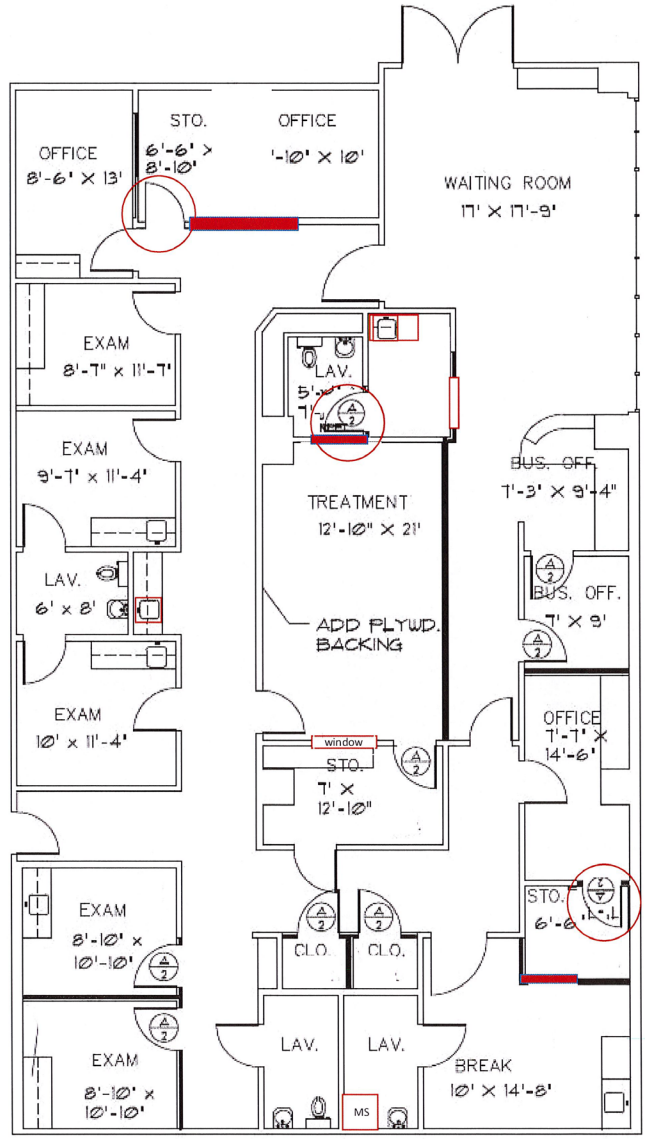


Contact Us

Angela Barber

Vice President
+1 832 455 6945
angela.barber@cbre.com

Danielle Parsons

Associate
+1 713 907 8905
danielle.parsons@cbre.com

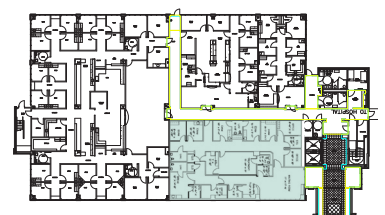

1st Floor