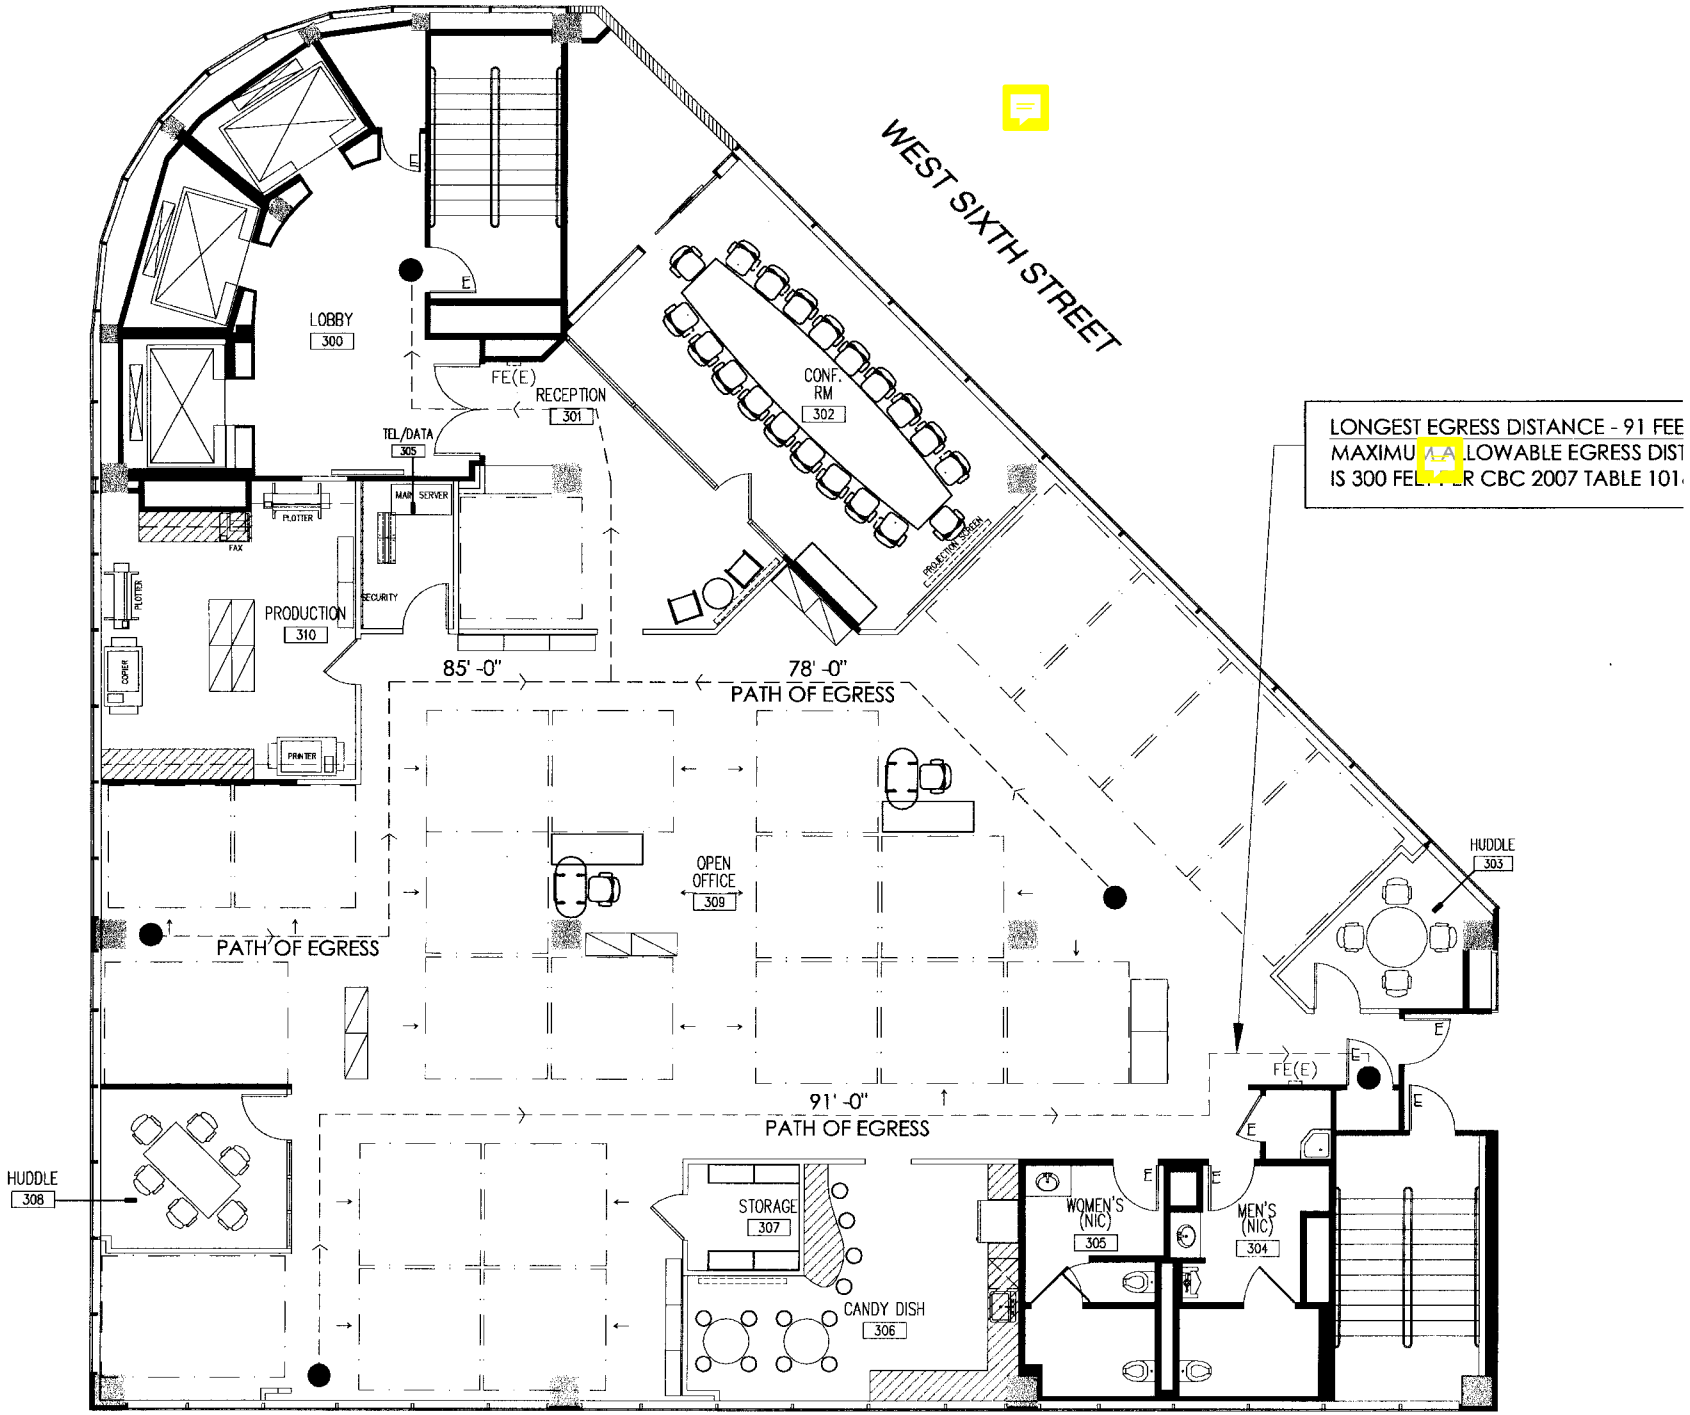

3RD FLOOR - FURNITURE PLAN - EGRESS

SCALE : 1/4" = 1'-0"